31/1E/13 A
START # 030119

File Original and First Copy with Department of Ecology
Second Copy — Owner's Copy
Third Copy — Driller's Copy

WATER WELL REPORT

STATE OF WASHINGTON

Application No. .....

Permit No. .....

(1) OWNER: Name Town of Coupeville Address Keystone Rd

(2) LOCATION OF WELL: County Island NE ¼ NE ¼ Sec. 13 T. 31 N., R. 1E W.M.

Bearing and distance from section or subdivision corner

(3) PROPOSED USE: Domestic ☐ Industrial ☐ Municipal ☑
Irrigation ☐ Test Well ☐ Other ☐

(4) TYPE OF WORK: Owner's number of well (if more than one) ?
New well ☑ Method: Dug ☐ Bored ☐
Deepened ☐ Cable ☐ Driven ☐
Reconditioned ☐ Rotary ☐ Jetted ☐

(5) DIMENSIONS: Diameter of well 8" inches.
Drilled 238 ft. Depth of completed well 228 ft.

(6) CONSTRUCTION DETAILS:

Casing installed: 8 " Diam. from 0 ft. to 208 ft.
Threaded ☐ " Diam. from ft. to ft.
Welded ☑ " Diam. from ft. to ft.

Perforations: Yes ☐ No ☑
Type of perforator used
SIZE of perforations in. by in.
perforations from ft. to ft.
perforations from ft. to ft.
perforations from ft. to ft.

Screens: Yes ☑ No ☐ Johnson
Manufacturer's Name
Type S.S. Model No. 304
Diam. 8 Slot size 12 from 208 ft. to 228 ft.
Diam. Slot size from ft. to ft.

Gravel packed: Yes ☐ No ☑ Size of gravel:
Gravel placed from ft. to ft.

Surface seal: Yes ☑ No ☐ To what depth? 18+ ft.
Material used in seal Bentonite, Cement
Did any strata contain unusable water? Yes ☐ No ☐
Type of water? Depth of strata
Method of sealing strata off

(7) PUMP: Manufacturer's Name
Type: H.P.

(8) WATER LEVELS: Land-surface elevation above mean sea level 200(+-) ft.
Static level 168 ft. below top of well Date
Artesian pressure lbs. per square inch Date
Artesian water is controlled by (Cap, valve, etc.)

(9) WELL TESTS: Drawdown is amount water level is lowered below static level
Was a pump test made? Yes ☑ No ☐ If yes, by whom? Driller
Yield: 64 gal./min. with 43 ft. drawdown after 24+ hrs.
" " " "
" " " "

Recovery data (time taken as zero when pump turned off) (water level measured from well top to water level)

Time	Water Level	Time	Water Level	Time	Water Level

Date of test
Bailer test 60+ gal./min. with 37 ft. drawdown after 8 hrs.
Artesian flow g.p.m. Date
Temperature of water Was a chemical analysis made? Yes ☐ No ☐

(10) WELL LOG:

Formation: Describe by color, character, size of material and structure, and show thickness of aquifers and the kind and nature of the material in each stratum penetrated, with at least one entry for each change of formation.

MATERIAL	FROM	TO
SAND + Gravel	0	63
Fine SAND - Some Clay	64	173
WATER HARD SAND Blue Clay	174	205
Very HARD Clay + Rock	206	207
Fine Water Sand - Hard	208	228
Brown Clay + Gravel	209	238

DEPT. OF ECOLOGY
NOV 14 1990

Work started 10/2, 19 90 Completed 10/19, 19 90

WELL DRILLER'S STATEMENT:

This well was drilled under my jurisdiction and this report is true to the best of my knowledge and belief.

NAME Well Done Drillers (Person, firm, or corporation) (Type or print)
Address 429 N. Valley Dr.
[Signed] Jack F. Jennis (Well Driller)
License No. 1304 Date 10/19, 19 90

(USE ADDITIONAL SHEETS IF NECESSARY)

ECY 050-1-20

31-1E-13J

Well Tagging Form

Unique Well Tag No: APH 105

RECORD VERIFICATION (check ✓ one)

☑ Well Report available (please attach this form to the well report and submit it to the Ecology Regional Office near you).
If a well report is not available, please complete a "Water Well Report for an Existing Well" form. This form is available at Ecology's headquarters office. **Do not use this form for wells that do not have a Water Well Report.**

WELL OWNERSHIP, IF DIFFERENT FROM WELL REPORT

First Name: Town of Coupeville Last Name:

Street Address: PO Box 725

City: Coupeville State: WA 98239

LOCATION OF WELL, IF DIFFERENT FROM WELL REPORT

Well Address: Parcel R13114-250-4610 Keystone Hill Road

City: Coupeville County: Island

T. 31 N. R. 1 E W.M. Sec. 13 NE ¼ of the SE

Latitude 48 ~~48~~. 10.54032 "

Longitude 122 38.31135 "

Elevation at land surface 180.0 feet ~~meters~~ *(circle one)*

SEE BACK SIDE OF PAGE...

RECEIVED
JUN 16 2008
DEPT. OF ECOLOGY

WELL CHARACTERISTICS

Location of Well identification Tag: strapped to the well casing

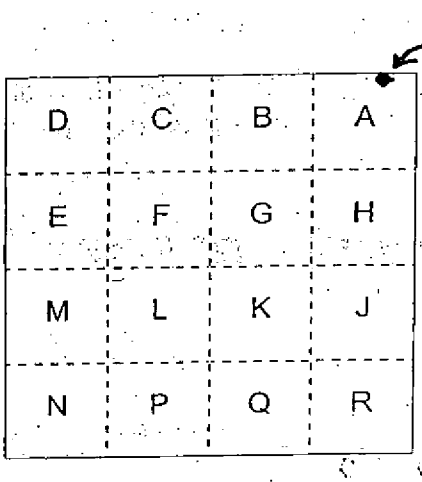

Scale 1:24,000 (1" = 2,000')

Indicate the location of the well within the Section by drawing a dot at that point

SECTION 13

COMMENTS: